

STATE OF IOWA
STATE HIGHWAY COMMISSION
DESIGN FOR
205'-0" x 20' PRE-STRESSED CONCRETE BEAM BRIDGE
And 12' x 10' RC BOX CULVERT
SECONDARY ROAD SYSTEM PROJ. S-1273(2)
CRAWFORD COUNTY
 SEPTEMBER 1957.

MILEAGE SUMMARY: = 207' 8 1/4" = 0.0393 MILES. Design 1257
 12'-0" = 0.00227 Miles Design 557

SPECIFICATIONS:
 Design: A.A.S.H.O. Series of 1953.
 Construction: Standard Specifications of the Iowa State Highway Commission, Series of 1956, plus Current Special Provisions except as noted.

DESIGN-1257, EAST BOYER TWP CRAWFORD COUNTY
SEC. 3-4, STA. 123+94.0 OVER EAST BOYER RIVER
205'-0" x 20' PRESTRESSED CONCRETE BEAM BRIDGE

DESCRIPTION.	ABUT'S.	PIERS.	SUPERSTRUCT.	TOTAL
CONCRETE Class - "C"	-CY			-CY
" Class - "A"	42.40 "	15.00 CY.	112.40 CY.	169.80 "
REIN. STEEL	2292 LBS.	2690 LBS.	24,591 LBS.	29,573 LBS.
STRUCT STEEL			3,724 "	3,724 "
TREATED PILING	18 @ 45' L.F.			810 L.F.
PRECAST CONC. PILING P10-B		14 @ 45' L.F.		630 "
PRE-STRESSED BEAMS			15 @ 67'-6"	15 @ 67'-6"
HANDRAIL Type "C"			414'-1" L.F.	414'-1" L.F.
EXCAVATION Class "20"	34 CY.			34 CY.
" Class "10"				1809 CY.
REMOVAL OF OLD STRUCTURE				LUMP SUM.


NOTE: Bridge Sign Assemblies Will be furnished & placed by Crawford County to Conform With S & T Instruction No. 11, revised March-1, 1957.

DESIGN-557, EAST BOYER TWP. CRAWFORD COUNTY.
SEC. 9-10, STA. 66+16.0 12' x 10' REIN. CONCRETE BOX CULVERT.

CONCRETE	REIN. STEEL	EXCAVATION	REMOVAL OF OLD STRUCTURE
132.40 C.Y.	14,304 LBS.	174 C.Y.	LUMP SUM.

DESIGN No. - 557
 PROJECT No. - S-1273(2)

DESIGN No. - 1257
 PROJECT No. S-1273(2)

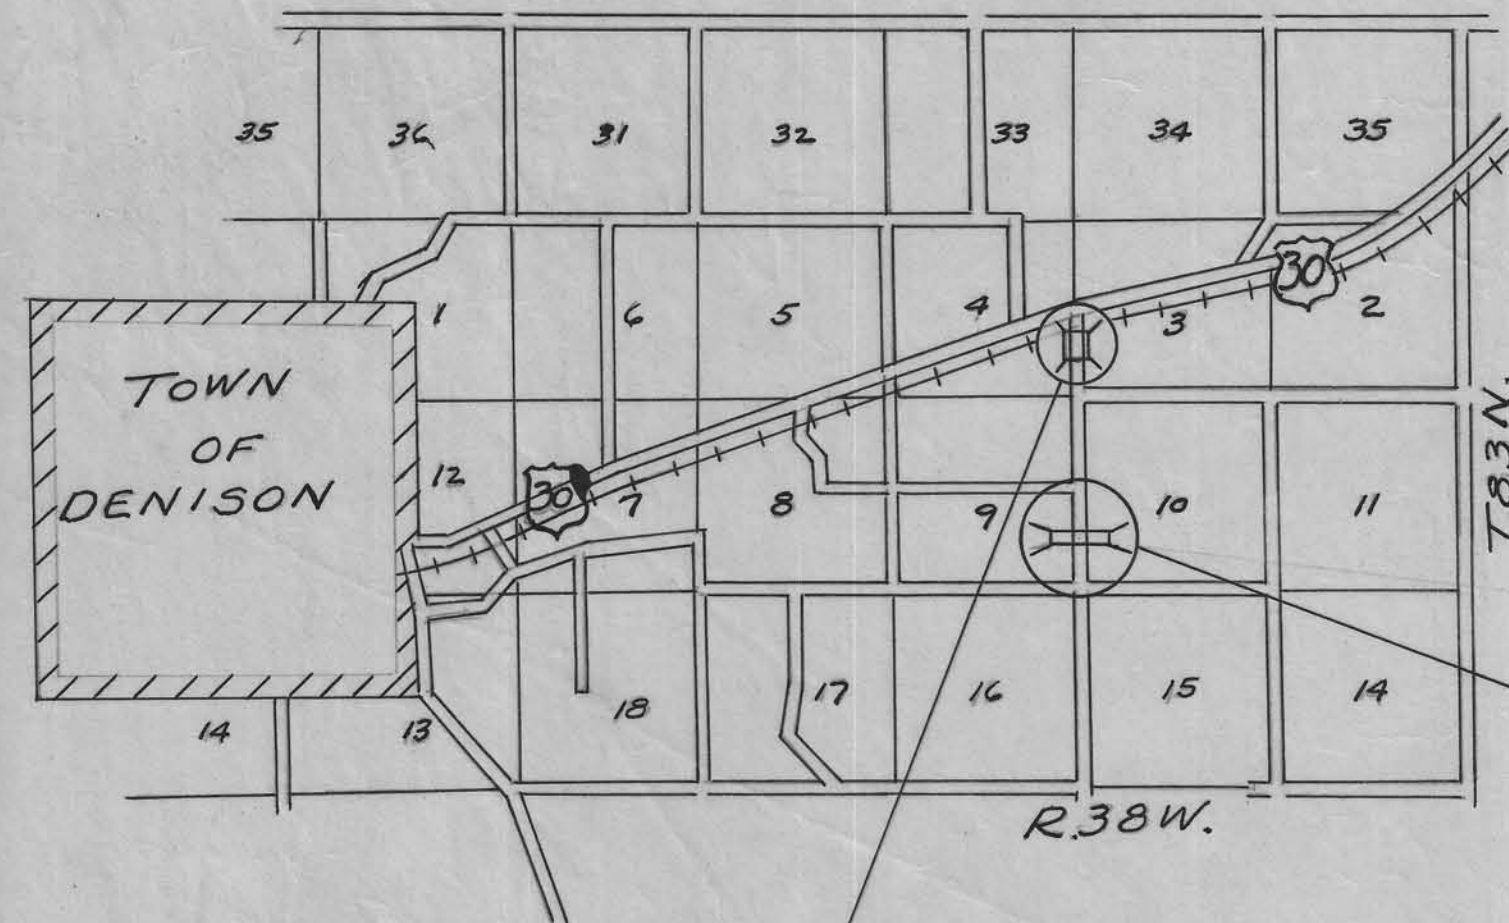

APPROVED

[Redacted Signature]

APPROVED

CHIEF ENGINEER DATE
 IOWA HIGHWAY COMMISSION

DEPARTMENT OF COMMERCE
 BUREAU OF PUBLIC ROADS
 RECOMMENDED FOR APPROVAL

DISTRICT ENGINEER DATE

APPROVED.

DIVISION ENGINEER DATE

Note: Abutment Elevations
 Revised Dec 17, 1957.

BOARD OF SUPERVISORS DATE


off to low
 11-26-57



4 + 17 DEC. 16/57
 CRAWFORD COUNTY.

DESIGN, No. 557 & 1257 PROJ. No. S-1273(2) File #1943

Sheet # 1 of 4



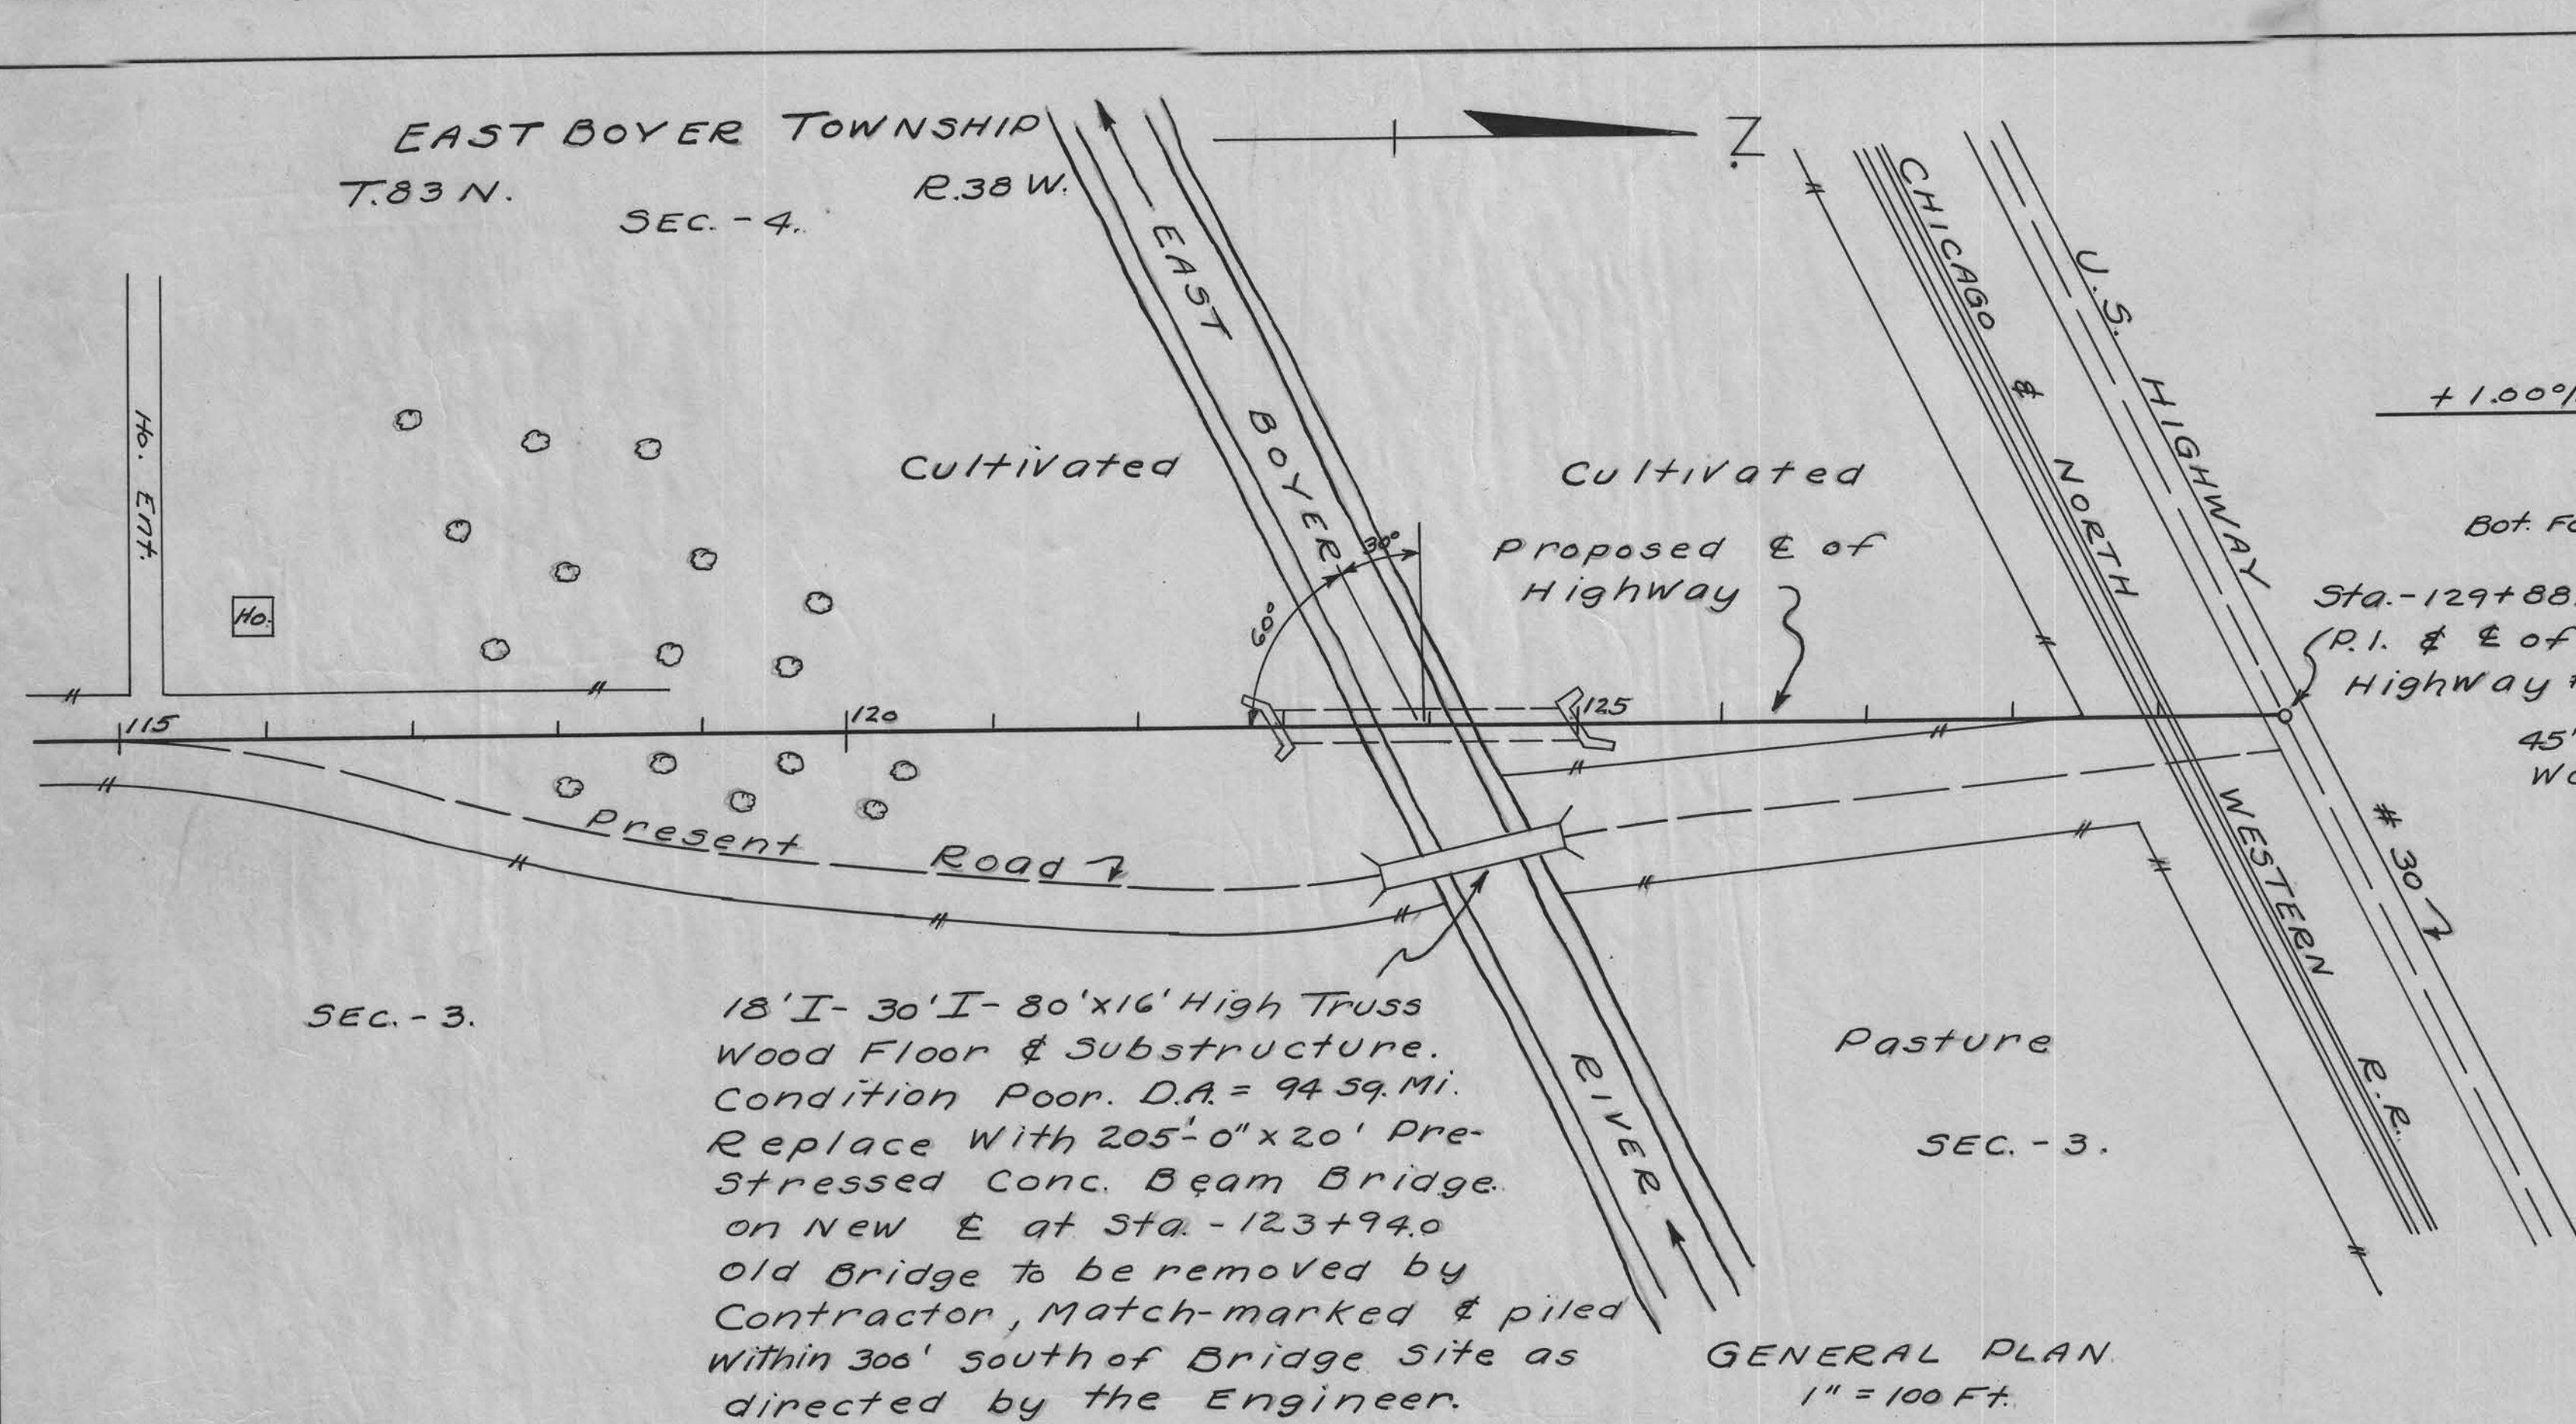


18'-30" I-80' x 16' High Truss Wood Floor & Substructure. Condition Poor. D.A. = 94.59 Mi. Replace with 205'-0" x 20' Pre-stressed Conc. Beam Bridge on New E at Sta. -123+94.0 Old Bridge to be removed by Contractor, Match-marked & piled within 300' south of Bridge Site as directed by the Engineer.

GENERAL NOTES:




Rail is to be anchored into Conc. Wing post as shown on Standard H10-3. The Floor Slab is to be thickened over the piers & Abutments to compensate for the Natural Camber of the Pre-stressed beams. Shots should be taken after the beams are in place but before the slab is poured and a new grade layed over the bridge. This will usually revise the grade a fraction of an inch. An allowance should be made for deflection of the beams due to the weight of the slab (Approx. 1/16" for 67'-6" beams). All exposed corners of 90° or sharper are to be filleted 3/4". Reinforcing bars are to be securely wired in place & supported on bar chairs before conc. is placed. Forms for slab are to be supported by the Pre-stressed beams. Bridge Seats for both Piers & Abutments are to be stepped as shown to provide for Crown of Roadway. For details of Super-structure refer to Sheet P-C-5. For sub-structure refer to Standard P-10 for Piers & H10-3 for Abuts. With modifications Shown on Sheet #4 of these Plans. All Construction to be in accordance with the Iowa Highway Commission's Standards, Series of 1956 plus current Special provisions as noted.

modified to accommodate formed Steel beam rail.

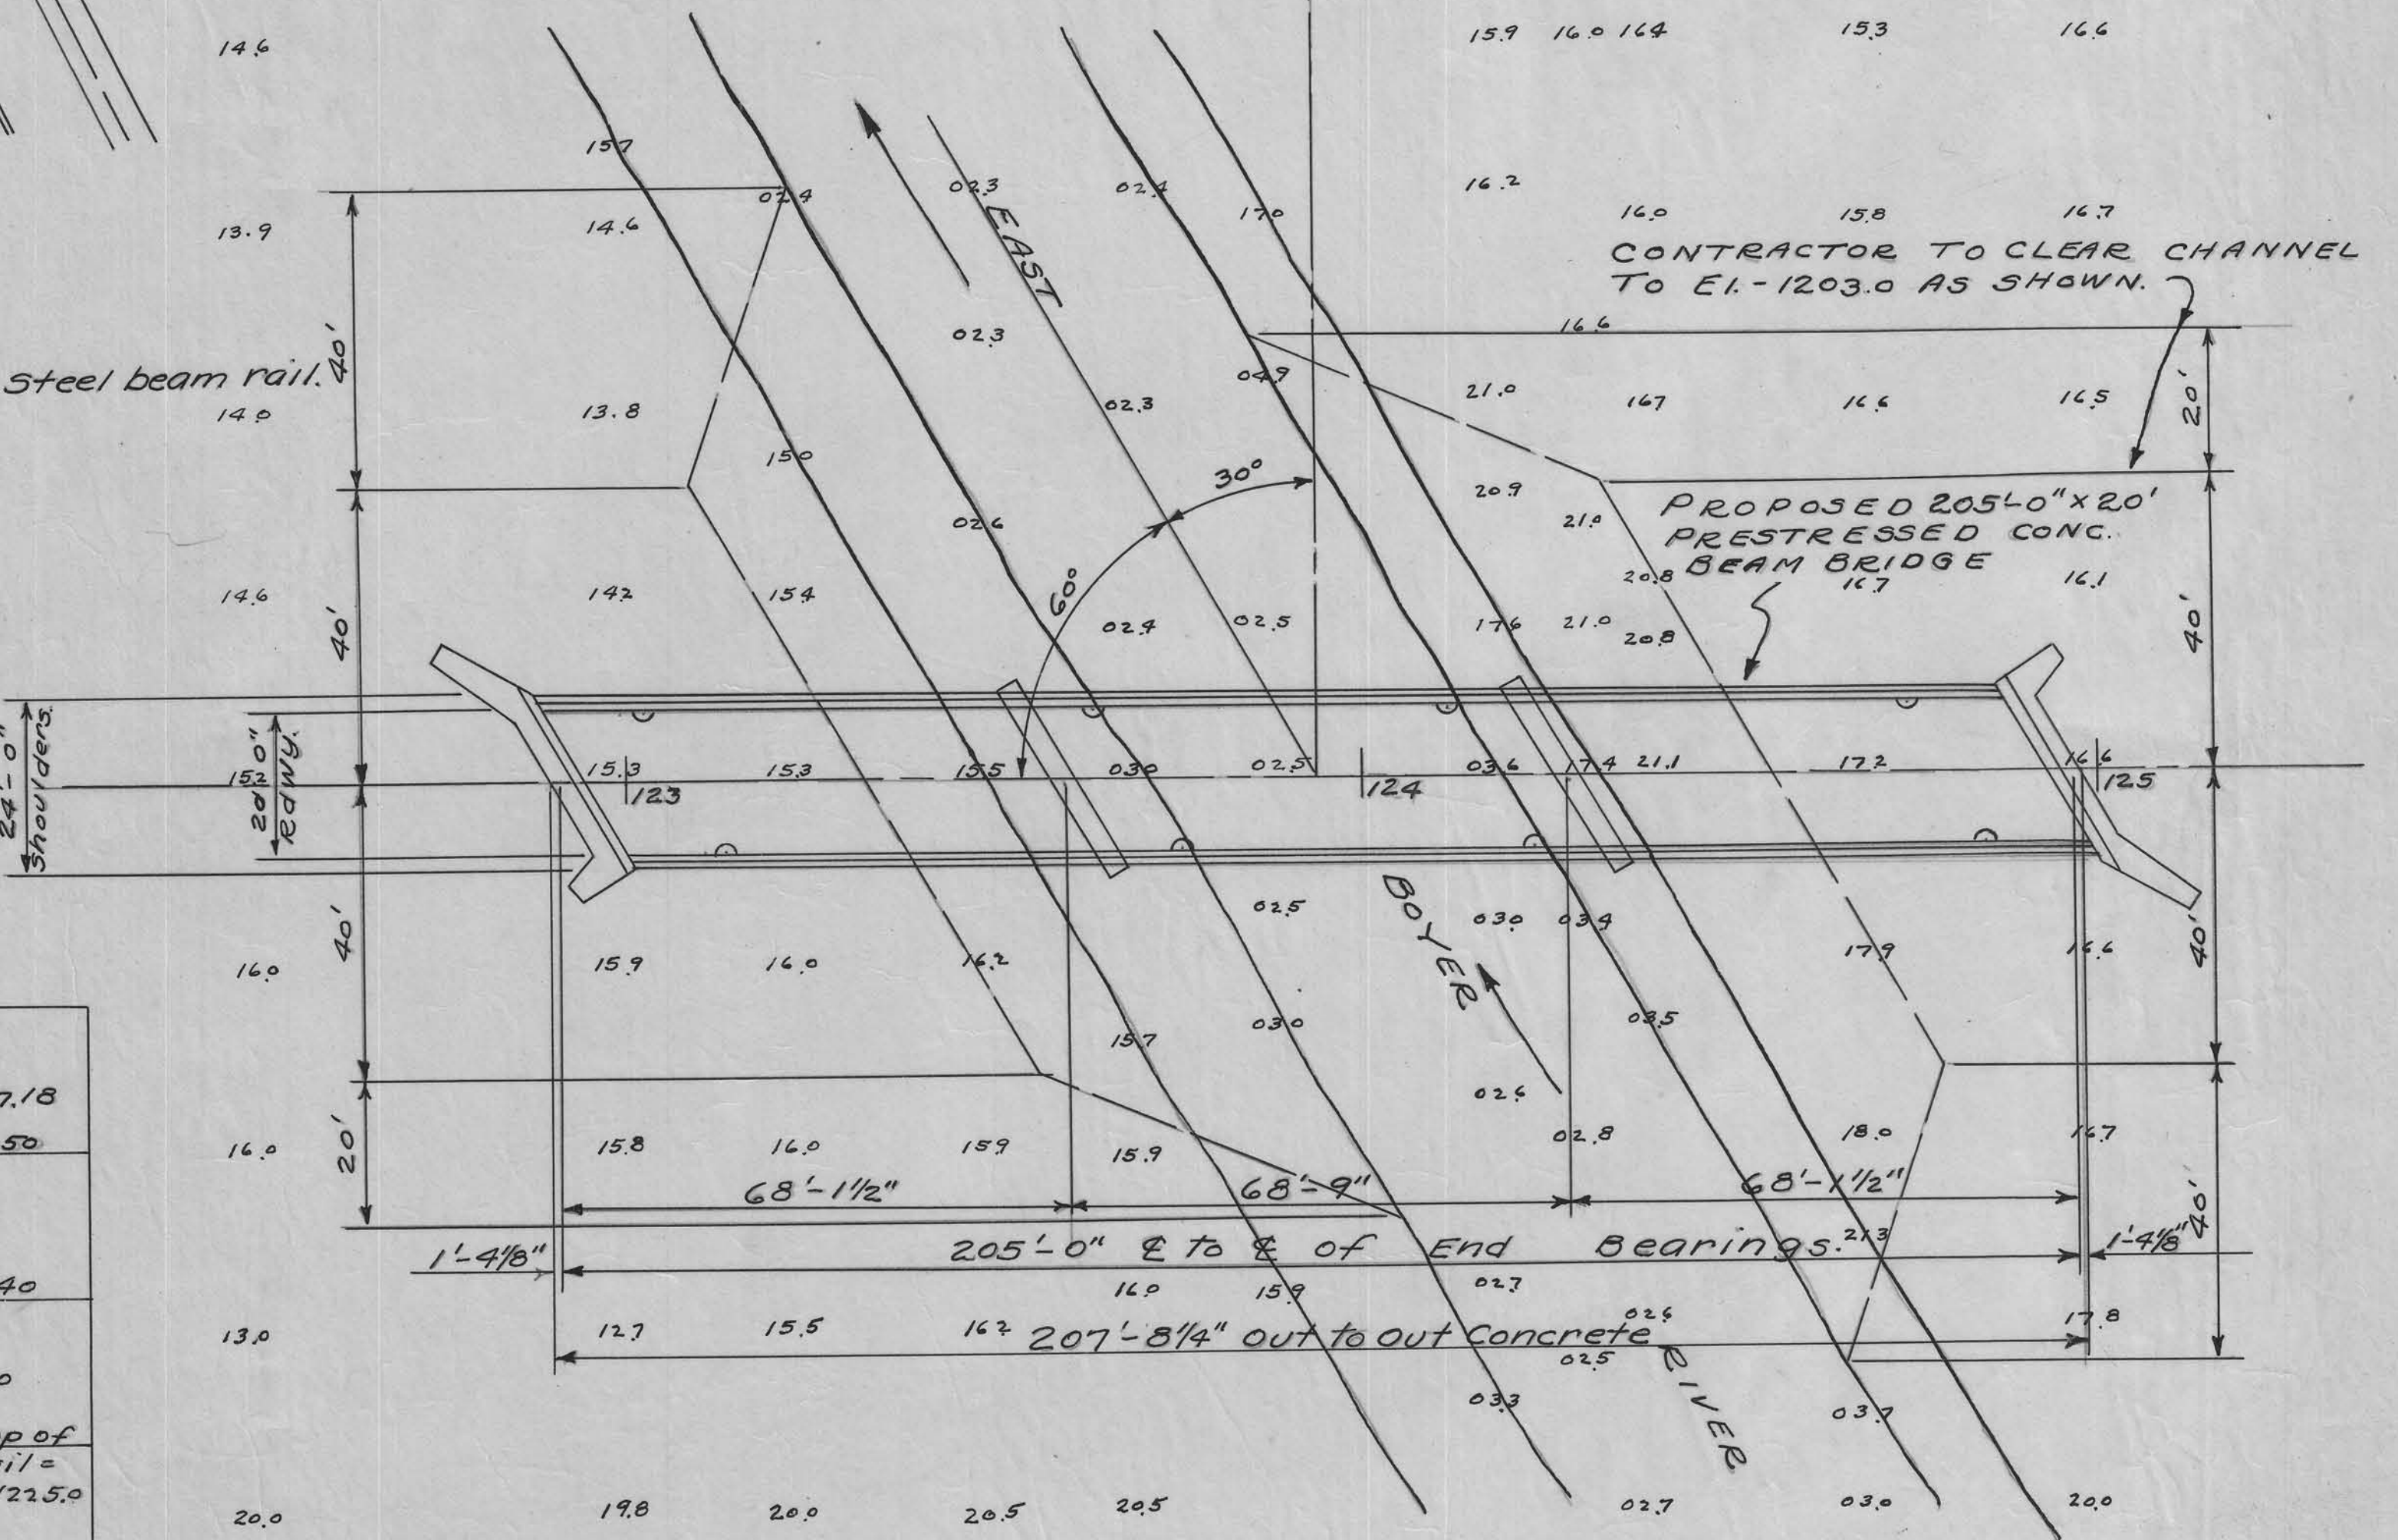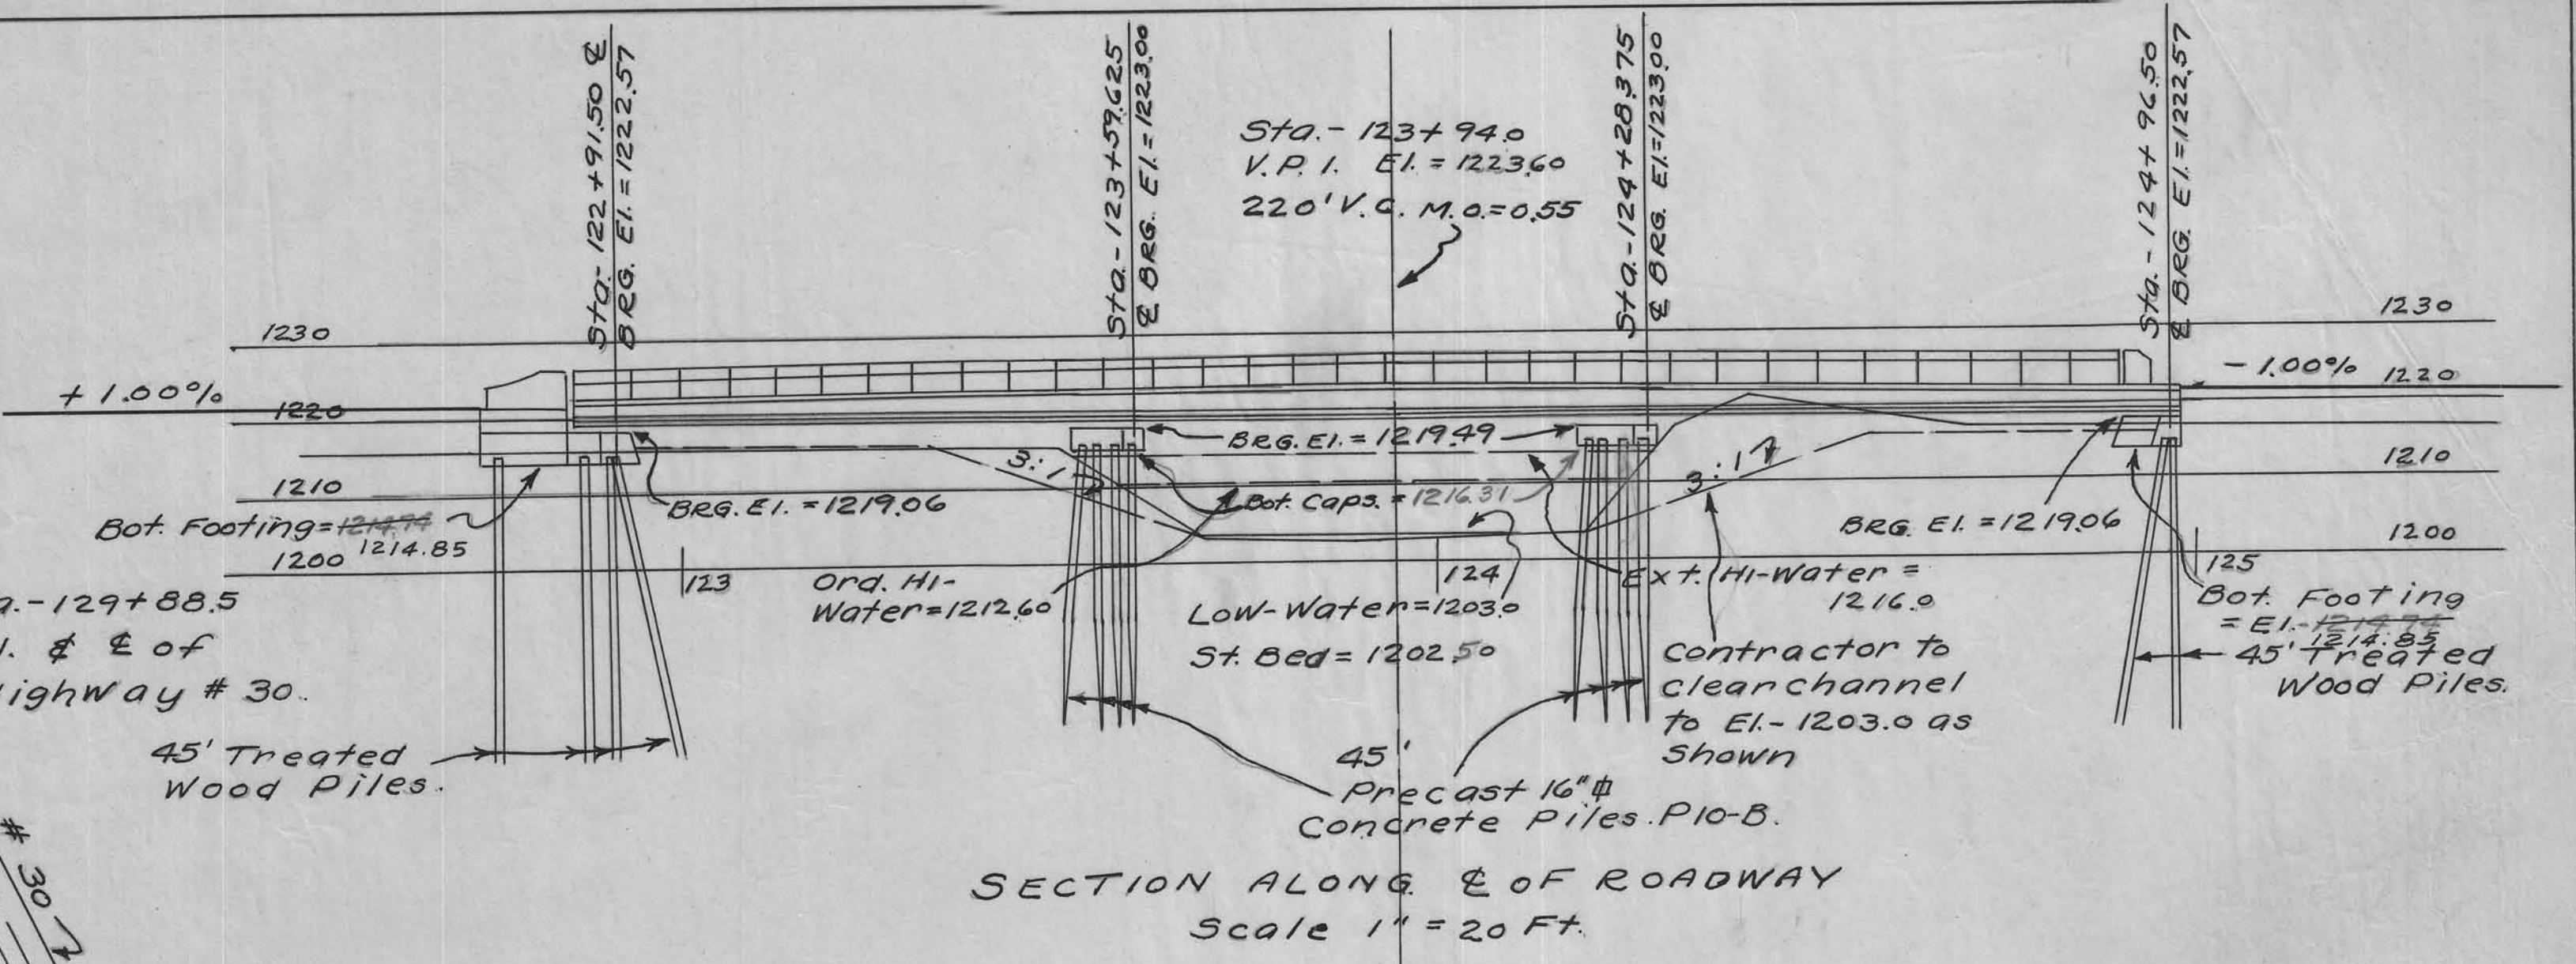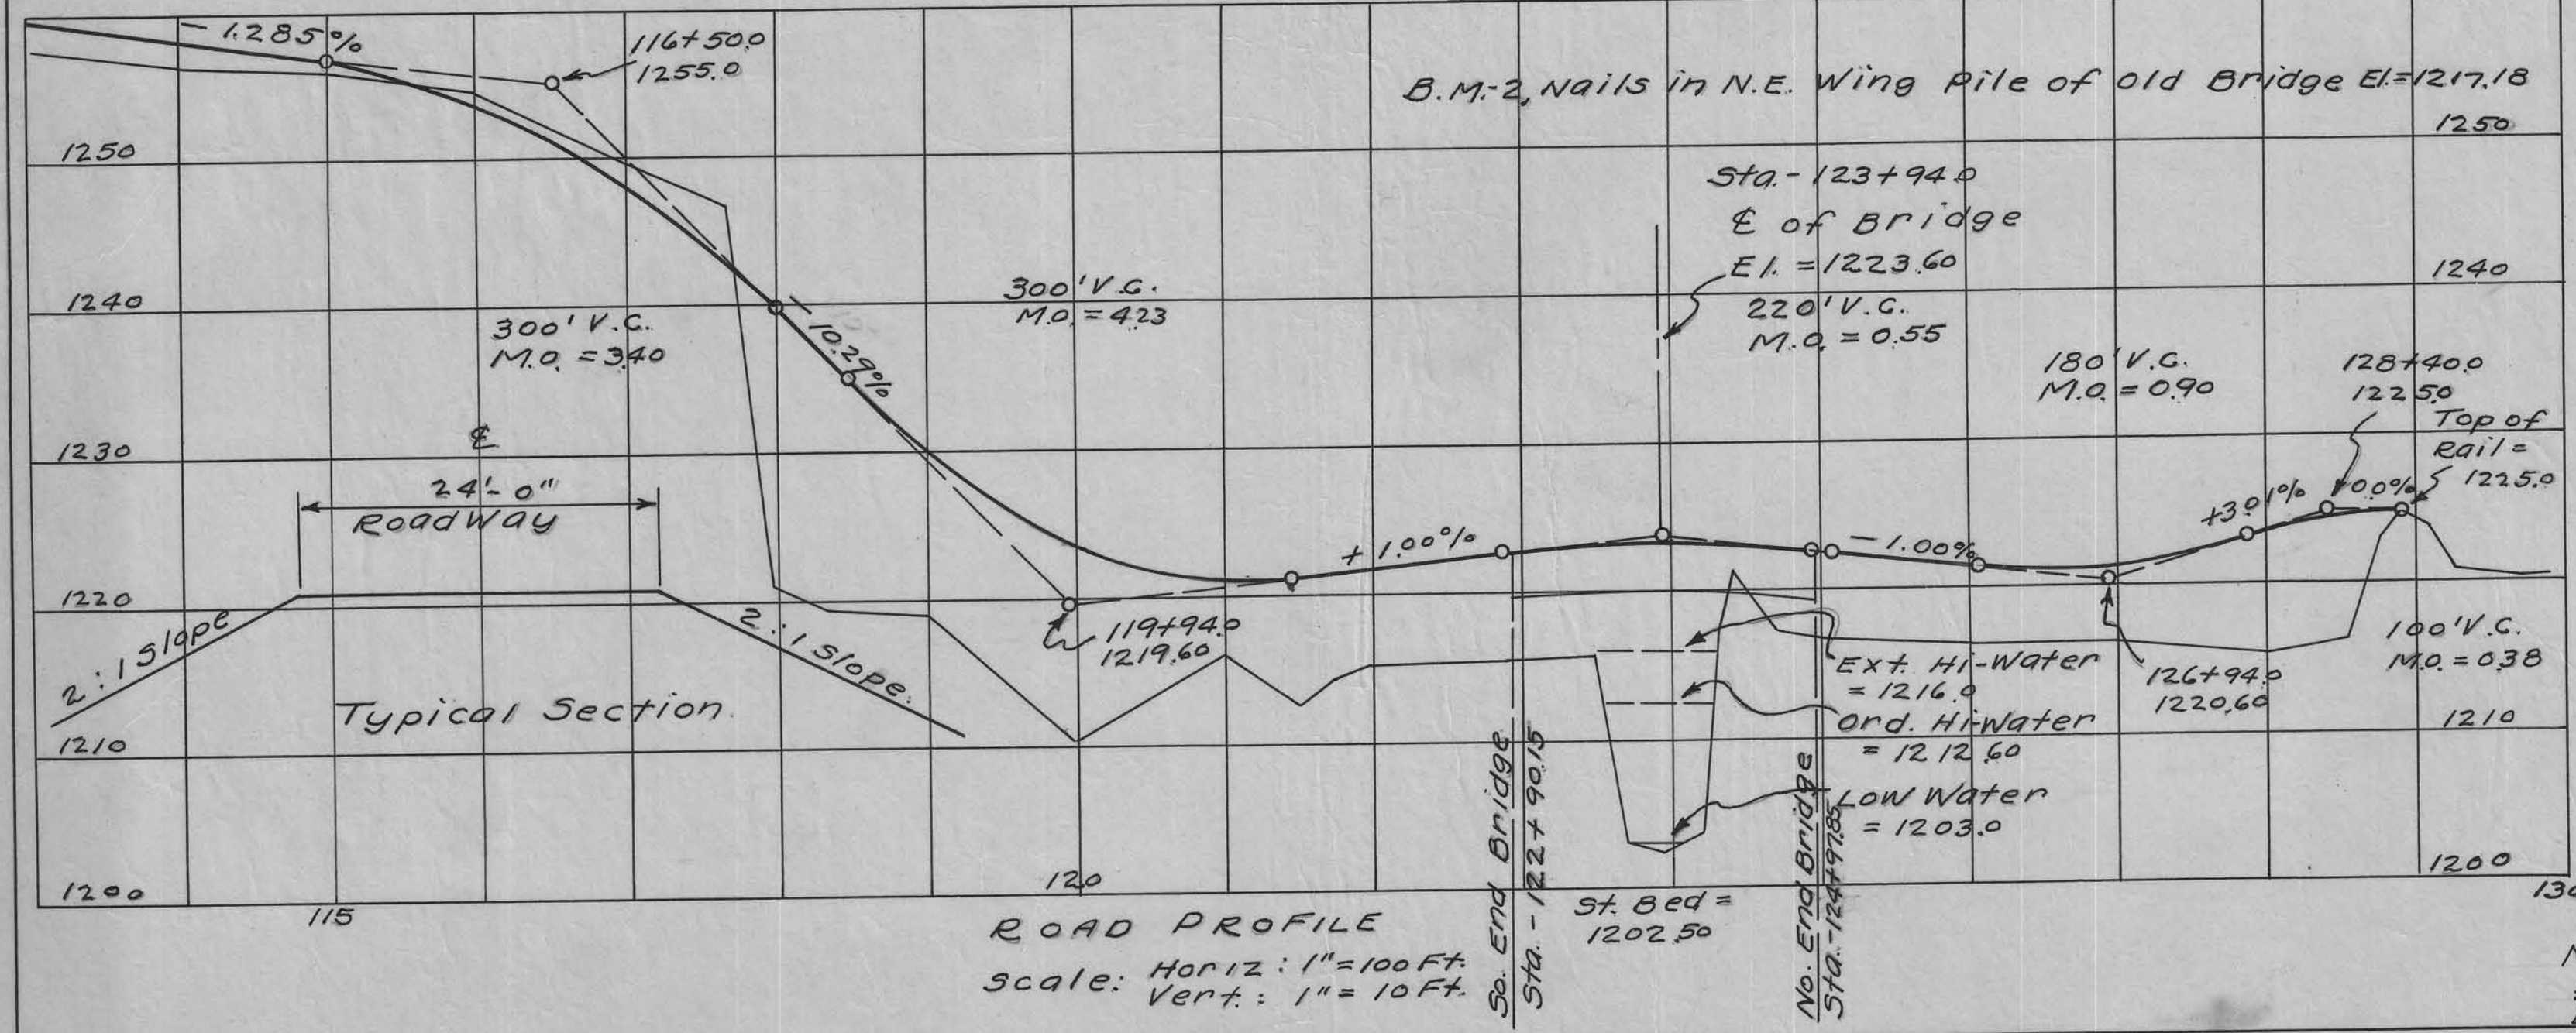


DESIGN FOR 30° SKEW
205'-0" x 20' PRE-STRESSED CONCRETE BEAM BRIDGE
CONCRETE FLOOR - STEEL HANDRAIL
Location Section 3-4
Sta. -123+94.0
East Boyer Twp.
T.83N. R.38W.
PROJECT No. 5-1273
CRAWFORD COUNTY, IOWA.

Note: Abutment bottom ftg elevation revised Dec. 17, 1957.

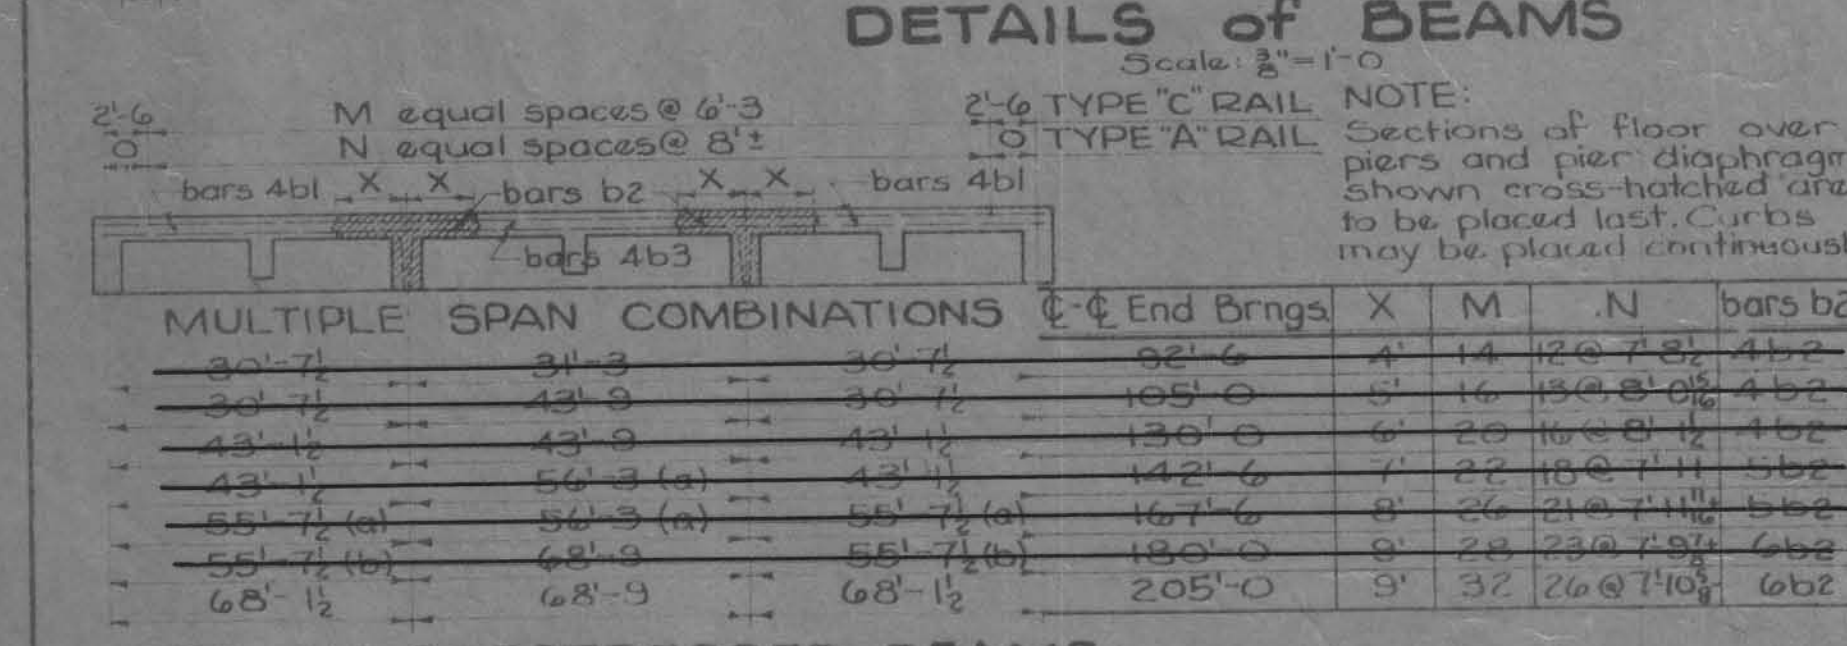
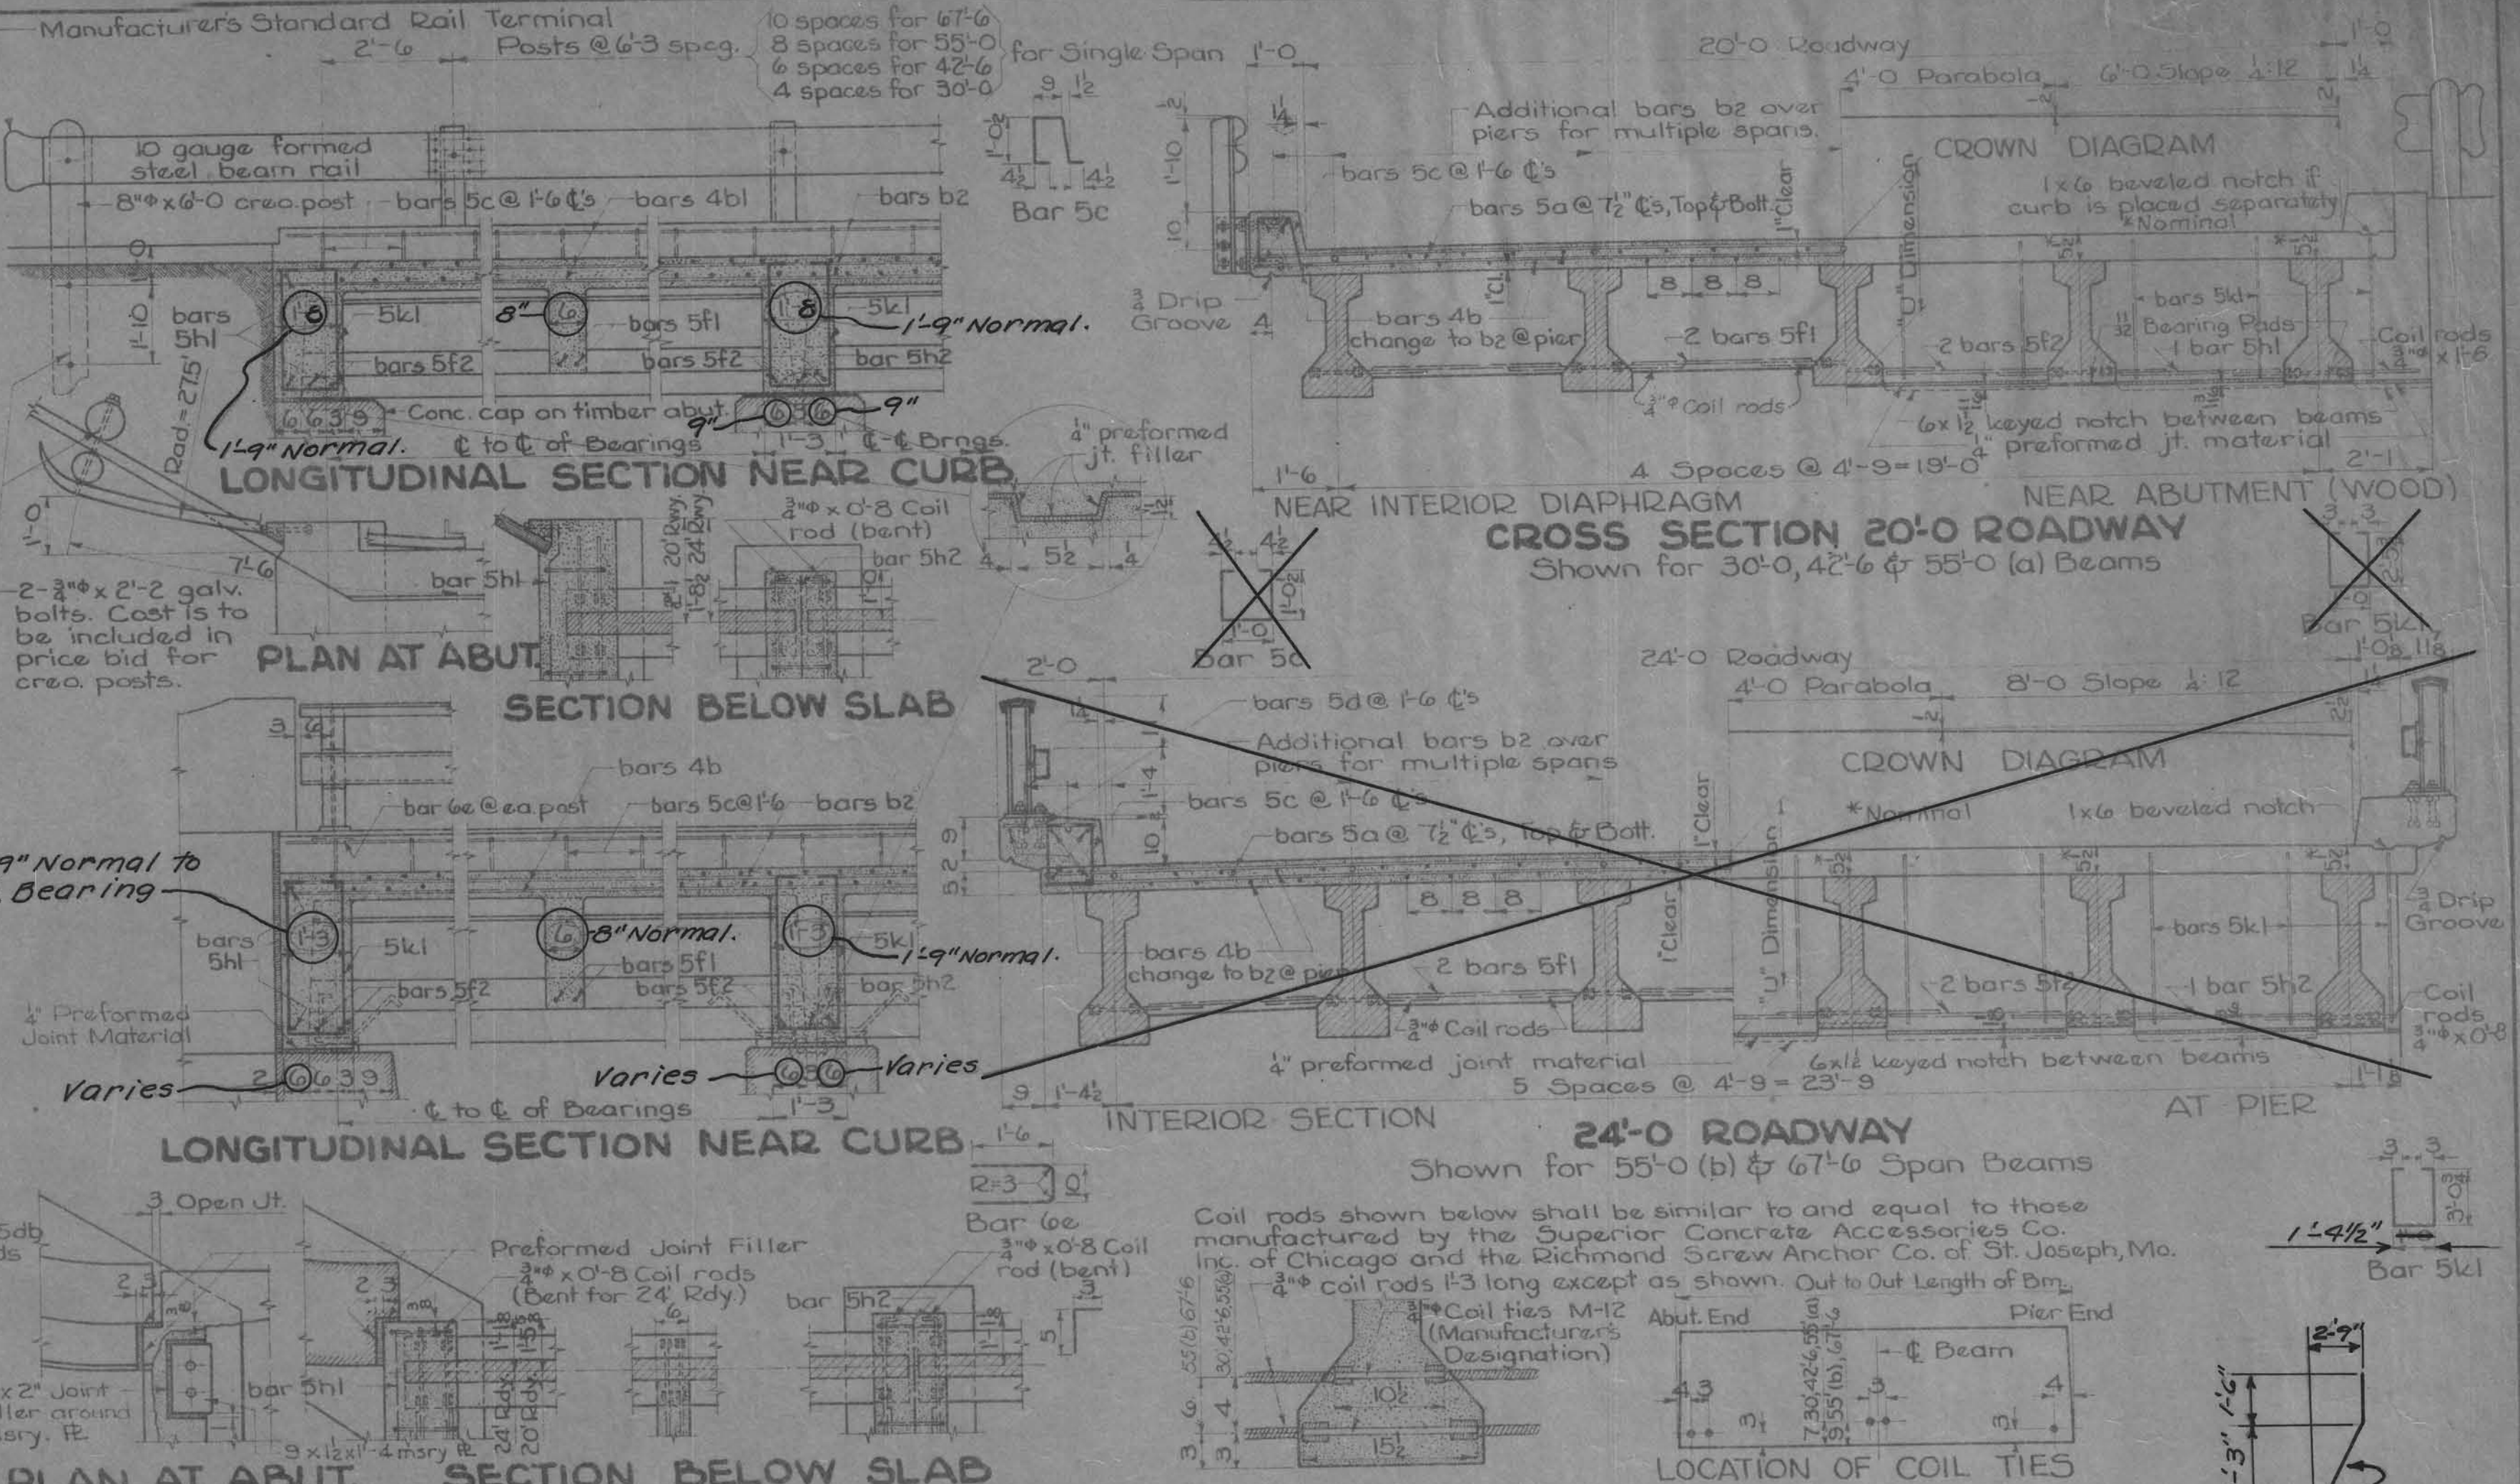
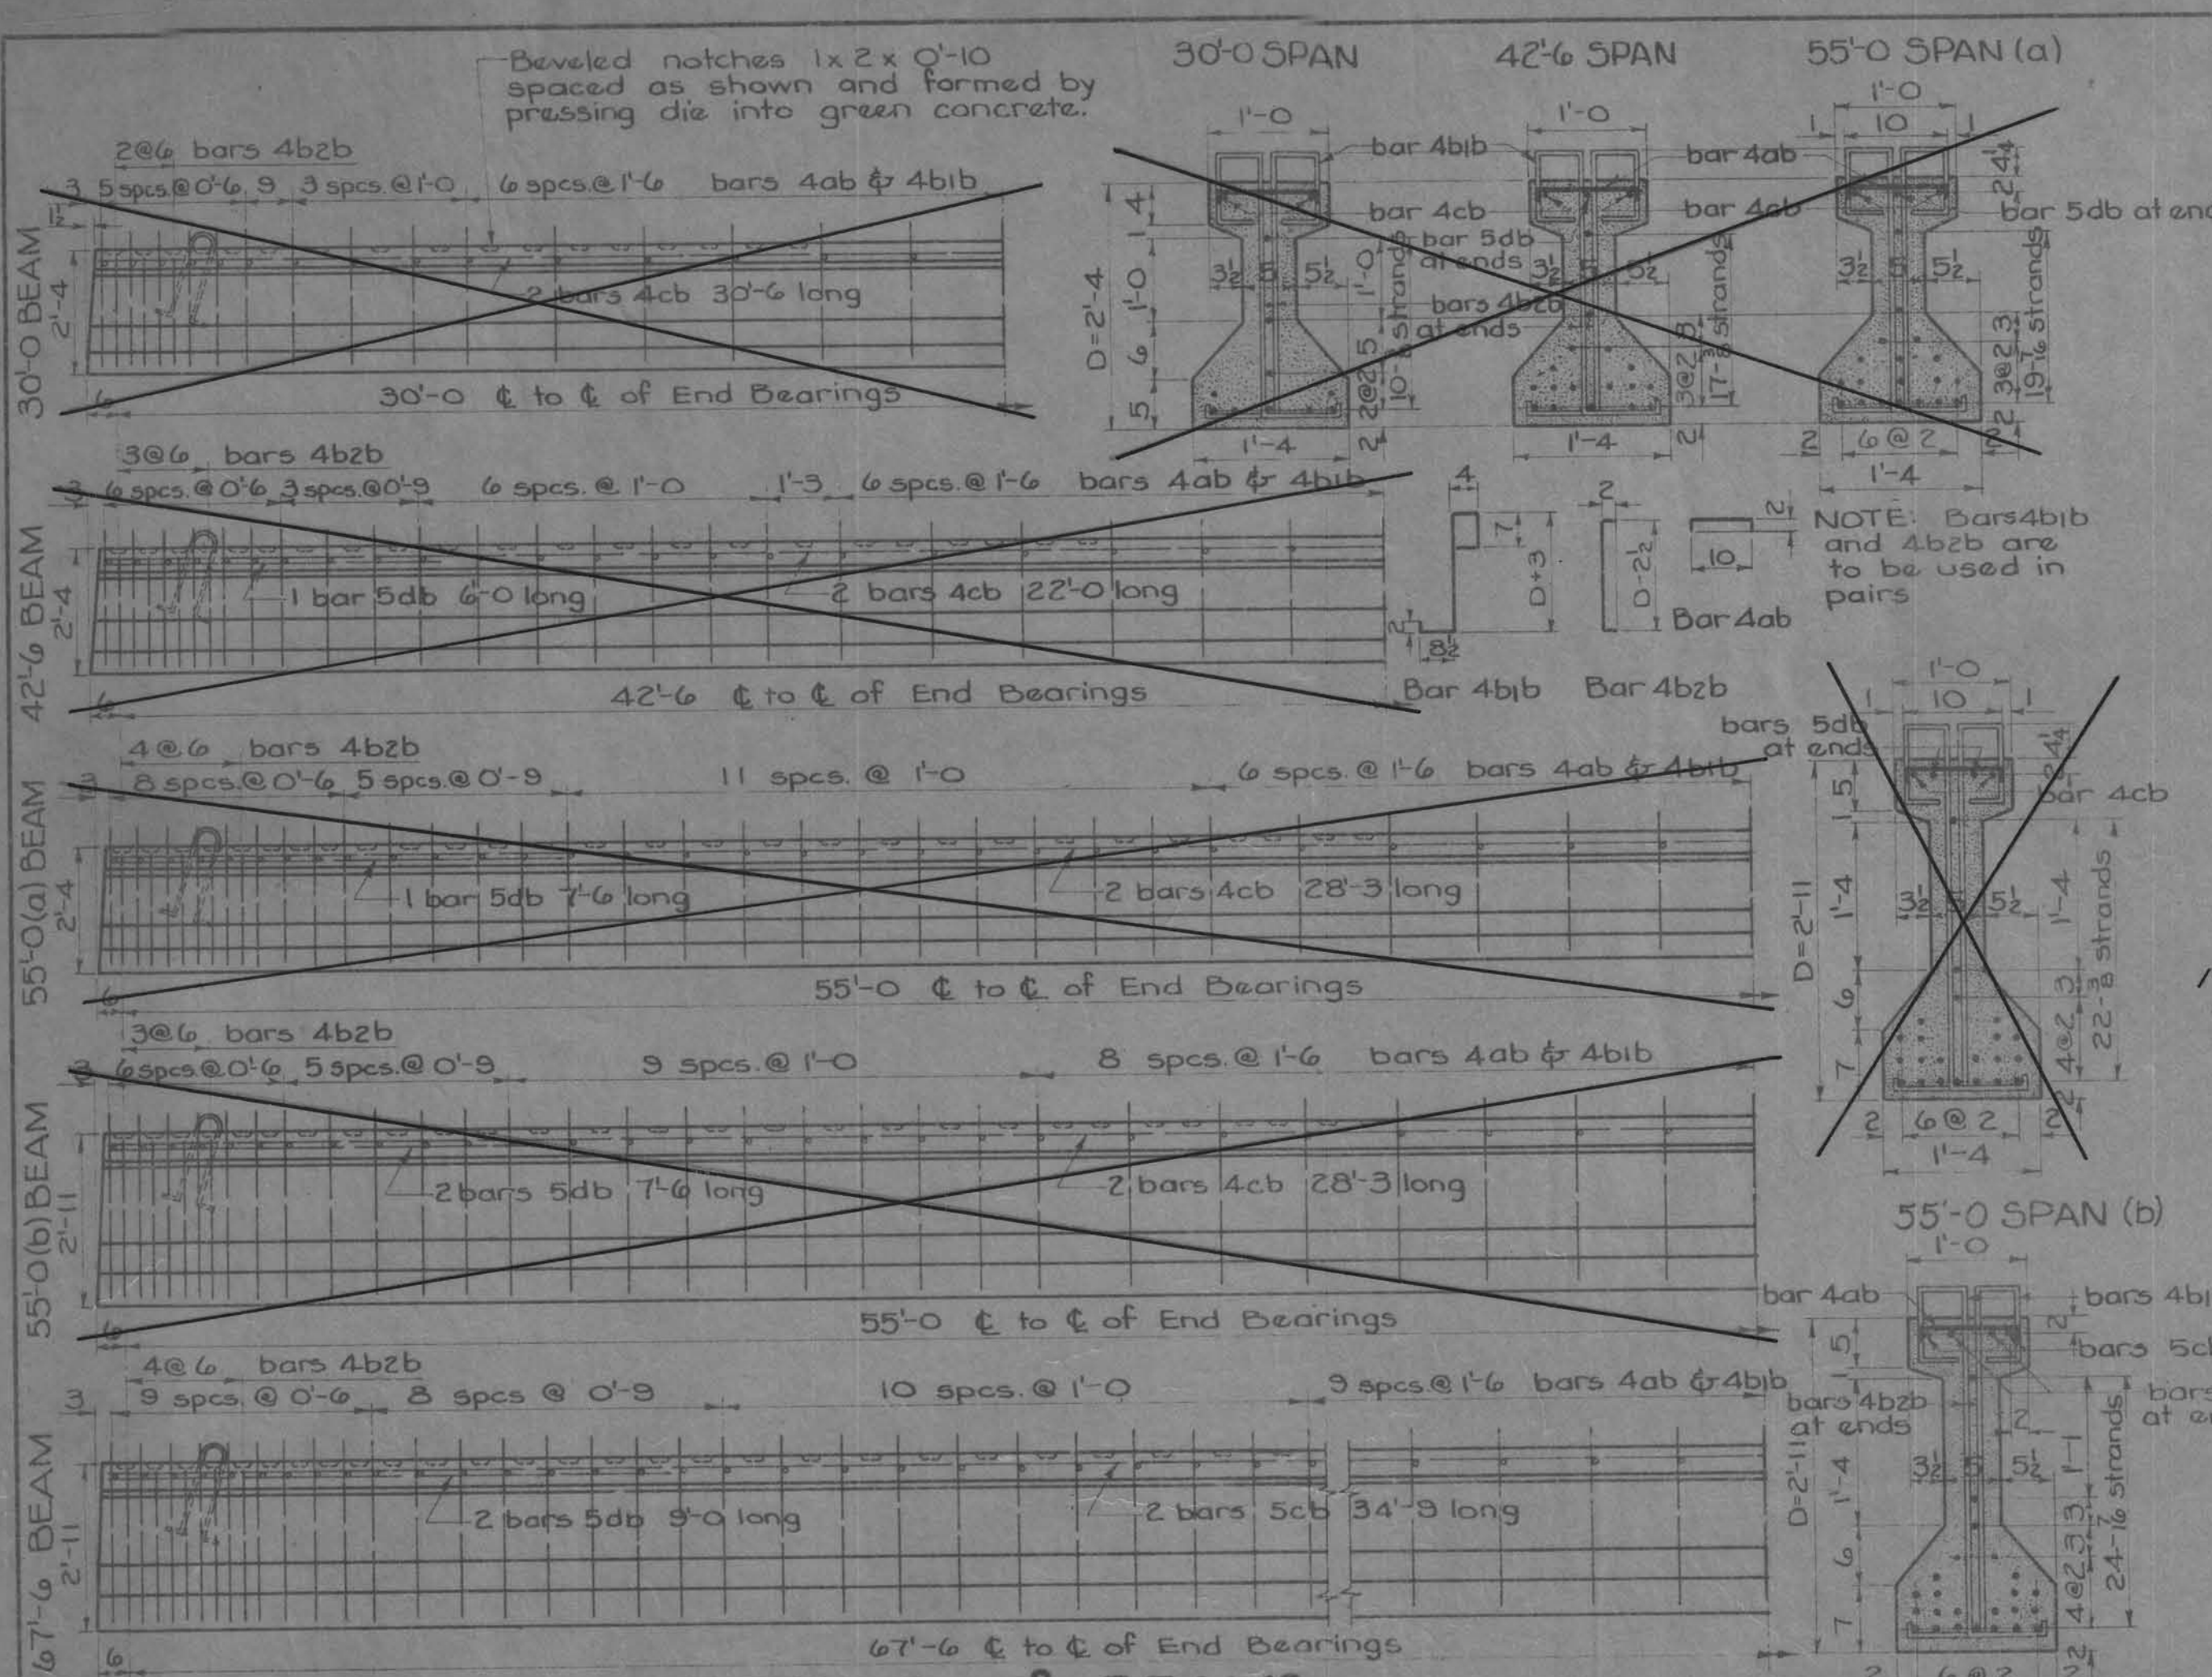


BEAM DATA						
SPAN	DEPTH	STRANDS	CONC. CY.	DEIN. STEEL lbs.	INITIAL PRE-STRESS lbs.	CAMBER AS Laid IN PLACE
30'-0"	2'-4"	10-3/8	2.06	262	217	140 k
42'-6"	2'-4"	17-3/8	2.90	393	217	238 k
55'-0"(a)	2'-4"	19-1/8	3.73	524	217	360 k
55'-0"(b)	2'-11"	22-3/8	4.66	557	217	308 k
67'-6"	2'-11"	24-1/8	5.70	759	217	453 k

NOTES ON PRESTRESSED BEAMS:
 Concrete in beams shall have a 28 day crushing strength of 5000 psi and a minimum of 4500 psi when stress is released. It shall contain no Class V aggregate. The maximum size of coarse aggregate shall be 1".
 Prestressing tendons shall be 7 wire strands of high strength uncoated wire, stress relieved after stranding with a modulus of elasticity of about 25,000,000, ultimate breaking strength of 27,000 lbs. for 1/8 strands and 20,000 lbs. for 3/8 strands, yield strength (0.2% offset) of 85% of the ultimate and minimum elongation in 10" of 4%. Strands are to be initially stressed to 70% of the ultimate - 13,300 for 1/8 and 14,000 for 3/8. Stress is to be determined by the measured elongation and checked by gauges on calibrated jacks.
 After release of strands beams are to be supported at all times near ends and handled by means of lifting loops near ends of beams.
 * carriage bolts - 2" holes in I, 1 1/2" holes in R, wrought washers
 Provide 4 2x4x0.5 slings for ea. pier
 (6) 1/2" (bent) 1" O.D. Lap with traffic

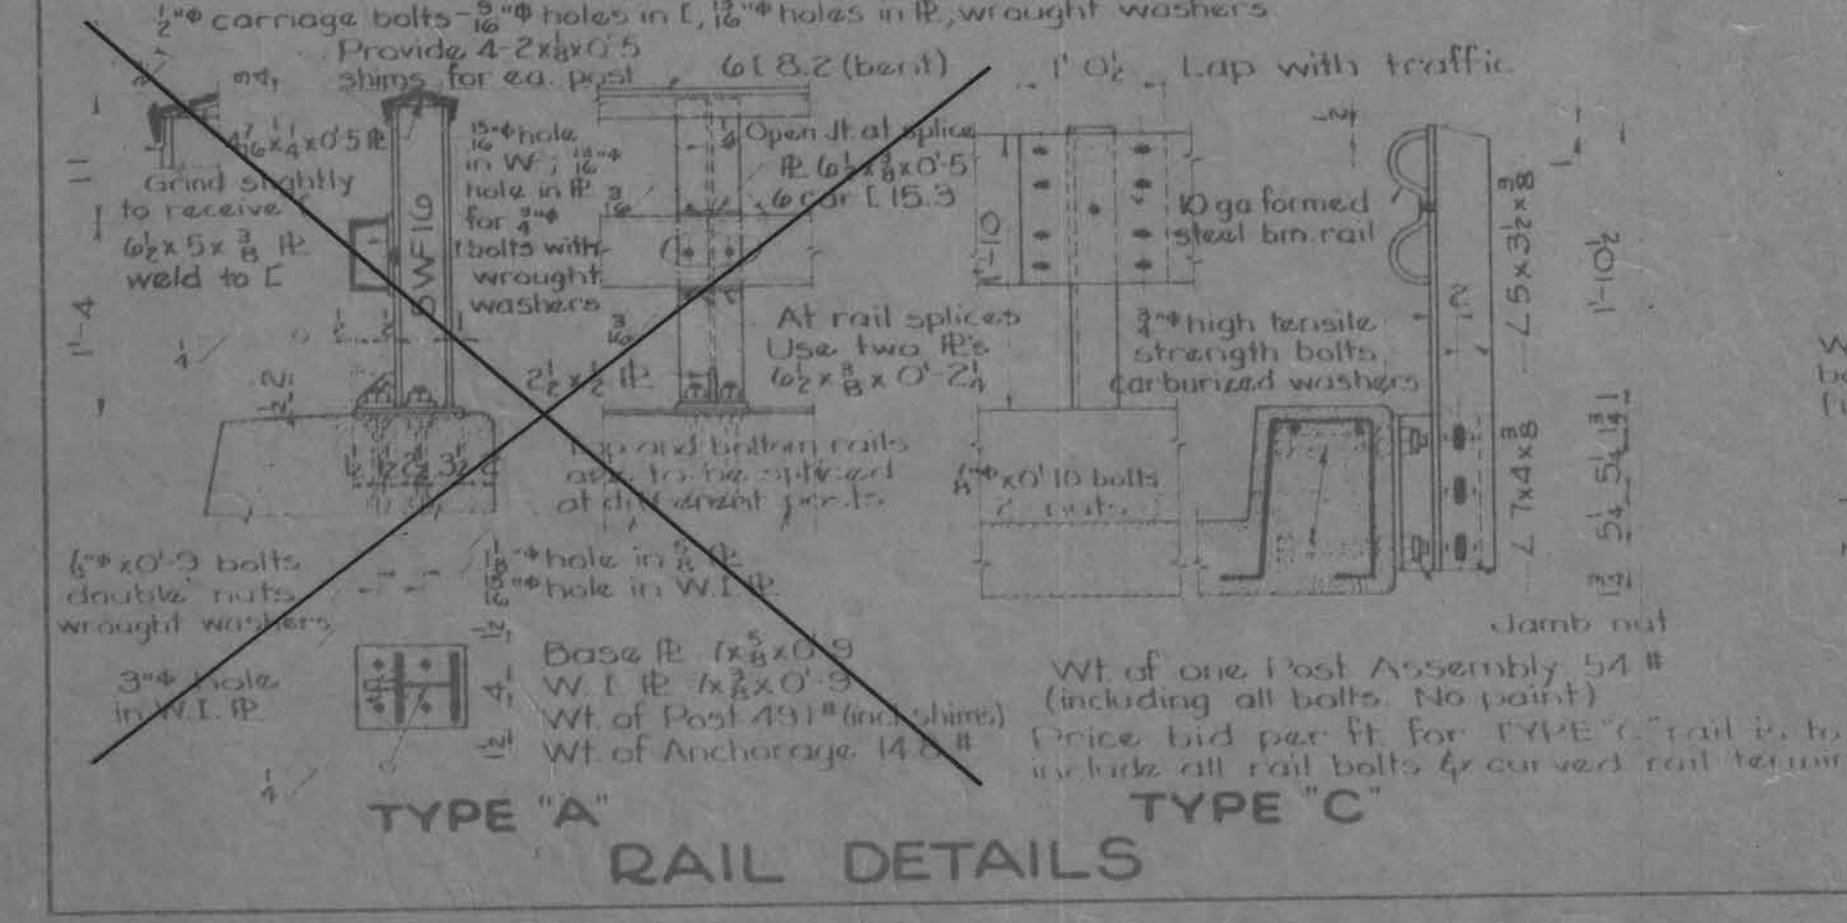

BILL OF REINF. STEEL for ONE BEAM						
BAR SHAPE	No	Length	No	Length	No	Length
4ab	31	1'-2"	45	1'-2"	61	1'-2"
4b1b	62	4'-4"	90	4'-4"	122	4'-4"
4b2b	12	2'-5"	16	2'-5"	20	2'-5"
cb	4	2'-30"	4	2'-0"	4	2'-3"
5db	-	-	2	6'-0"	2	7'-6"
TOTAL WT.	262	393	524	557	759	

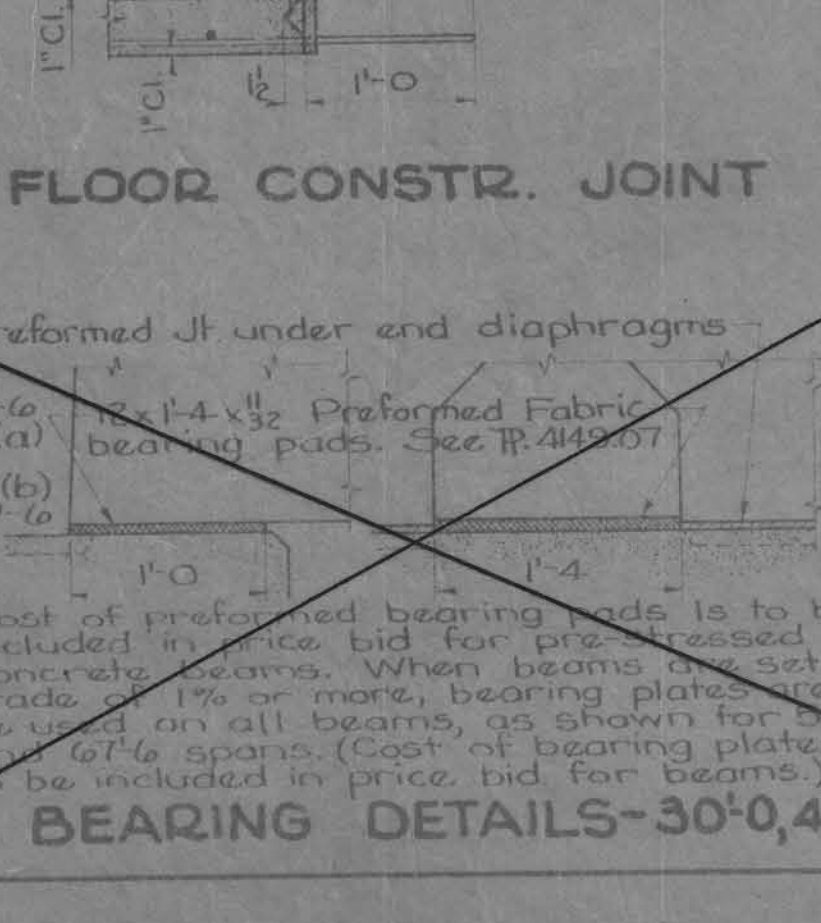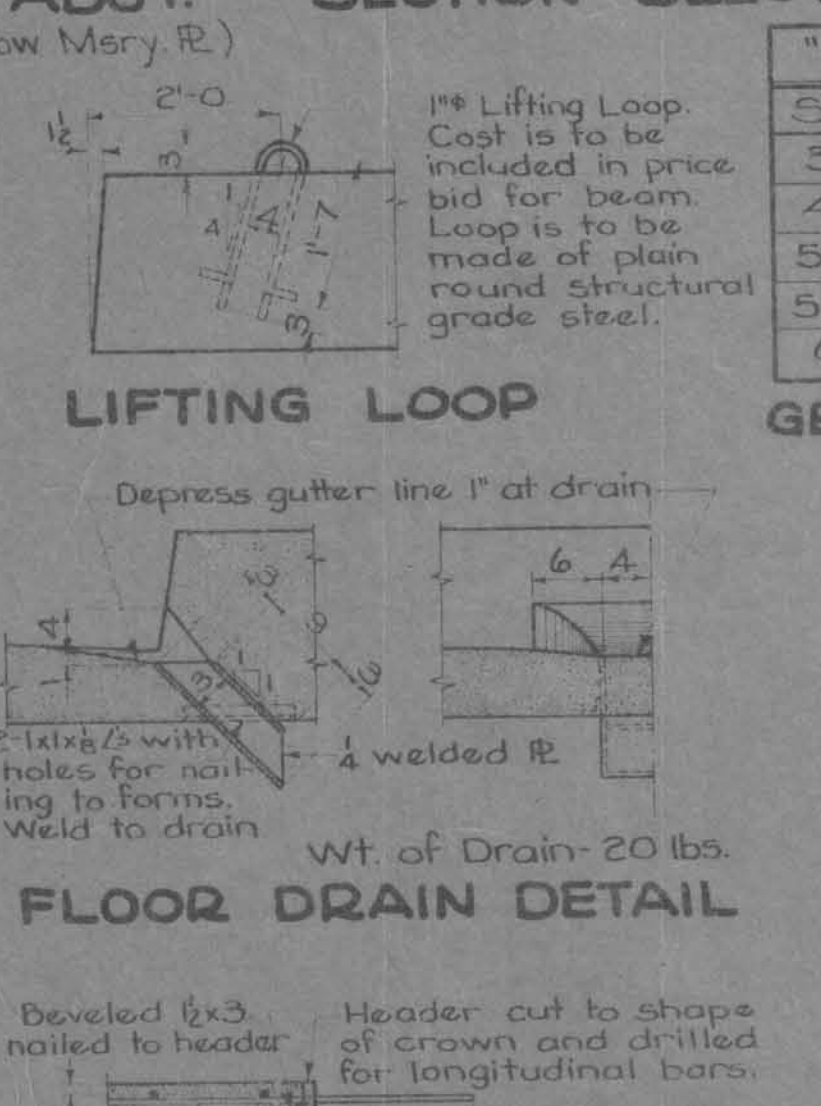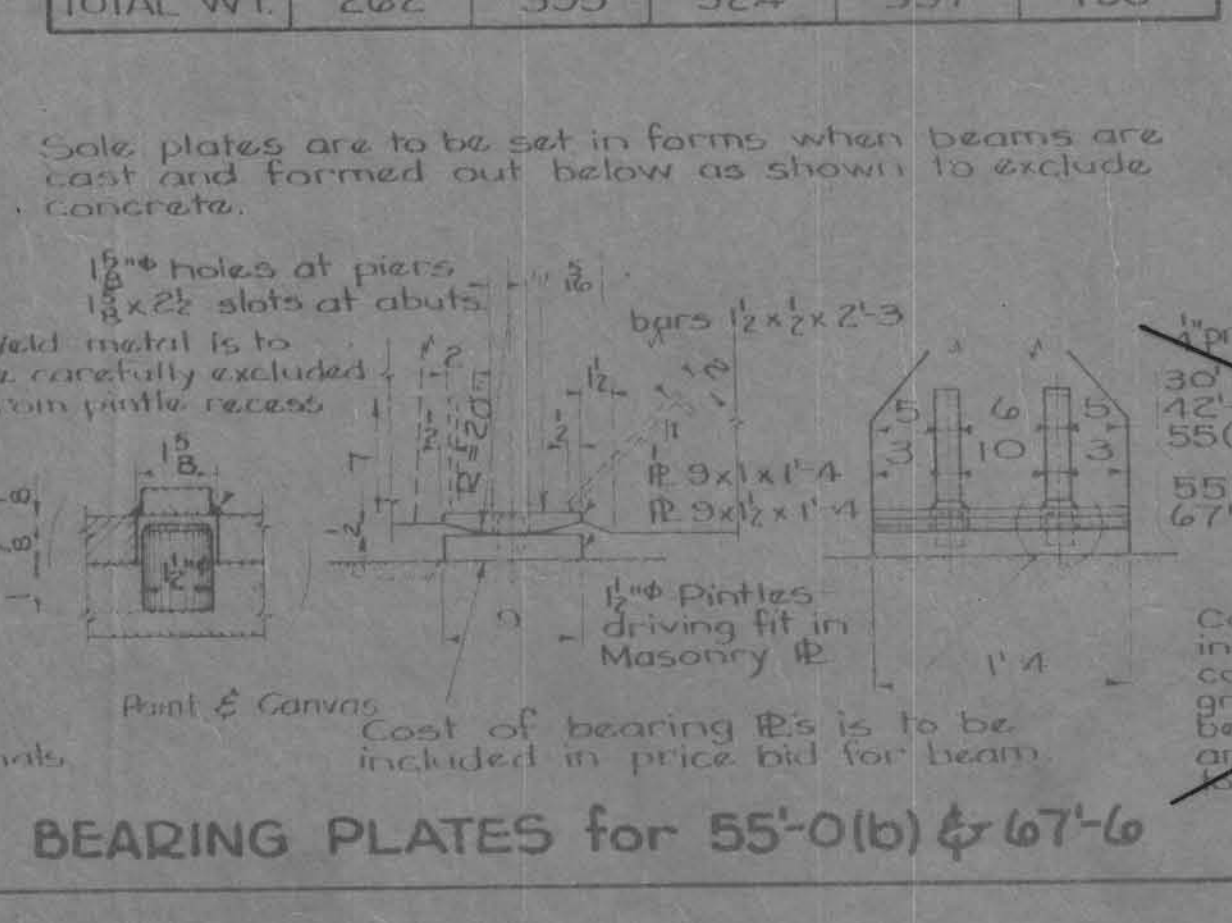

GENERAL NOTES:
 These bridges are designed for H15-44 loading. The two types of rail and curb shown may be used interchangeably on the 20'-0" and 24'-0" roadways. All spans may be used with timber abutments similar to Standard H10-2, concrete slab abutments similar to Standard H10-3, or other types of rigid concrete abutments. When used in multiples as shown they should be set on flexible type piers.
 Slab concrete is to have a 28 day crushing strength of 3500 psi and is to contain no Class V aggregate. It is to be placed as dry as practicable to reduce shrinkage to a minimum and special precautions are to be taken to secure complete bond between slab and beams.
 All exposed corners of 90° or sharper are to be filleted.
 All reinforcing bars are to be securely wired in place and adequately supported on bar chairs before concrete is placed.
 Forms for slab are to be supported by the prestressed beams.
 Bridge seats of both abutments and piers are to be stepped as shown due to crown of roadway. All beams are to be set vertical.
 Intermediate diaphragms are located at 1/2 of beams.
 For number and spacing of floor drains, see Situation Plan.
 Bridge seats of both abutments and piers are to be stepped as shown due to crown of roadway. All beams are to be set vertical.
 Intermediate diaphragms are located at 1/2 of beams.

SPECIFICATIONS:
 Design: A.A.S.H.O., Series of 1953, and United States Bureau of Public Roads Design Criteria for Prestressed Concrete Bridges, 1955 Construction: Standard Specifications of the Iowa State Highway Commission, Series of 1956, plus current Special Provisions except as noted.
 Location: Section 3-4, East Boyer Twp., T.83N. R.38W.
 Design# 1257 CRAWFORD COUNTY, Proj # 5-1273(2) Sheet # 4 of 4.
 Designed by: Traced by: Checked by:

BILL OF REINF. STEEL-SUPERSTRUCTURE			
BAR	LOCATION	SHAPE No	LENGTH WEIGHT
5a	Slab Transverse	70	14' 8" 15021
4b1	Slab Longitudinal	176	31'-0" 3645
6b2	Slab Lngtl. Over Piers	102	17'-8" 2707
4b3	Slab Longitudinal	88	26'-10" 1577
5c	Curb Dowels	276	3'-3" 936
5d	Curb Transv. (Type 'A' Rail)	24	4'-1" 102
5f2	Abut. & Pier Diaphs. Short	32	3'-9" 125
5h1	Abutment Diaphs Long	4	24'-6" 103
5h2	Pier Diaphragms Long	8	7'-5" 62
5k1	Abutment & Pier Hoops	40	7'-6" 313
			TOTAL = 24,591
ESTIMATED QUANTITIES-SUPERSTRUCTURE			
ITEM	UNIT	QUANTITY	
Concrete	cuyd	112.40	
Reinforcing Steel	lbs.	24,591	
Structural Steel	lbs.	3,724	
Pre-stressed Conc. Beams	Beam	15 @ 67'-6"	
Pre-stressed Conc. Beams	Beam		
Formed Steel Beam Rail	L.F.	414'-11" C	
Cresolated Wood Rail Posts	8"x6'-0" Post		

Design for PRE-TENSIONED PRE-STRESSED CONCRETE BEAM BRIDGES 30'-0", 42'-6", 55'-0" & 67'-6" SPANS 20'-0" AND 24'-0" ROADWAYS H-15-44 LOADING 205'x20' CONCRETE BEAM BRIDGE STA.-123+94.0 PROJ. No. 5-1273 Iowa State Highway Commission December 1956 Sheet PC-5

