


NE 60° 17'  
 DUG (2X8) 3' and FOUND  
 OLD CORNER LARGE ROCK  
 SET C-M

Ties from "X" nails  
 S14 SE from West Cor. P.  
 S49 S.E. from North Cor. P.  
 49.7 SW. from Cor. P.  
 48.7 N.W. from Cor. P.  
 45.9 N.W. from Power Pole

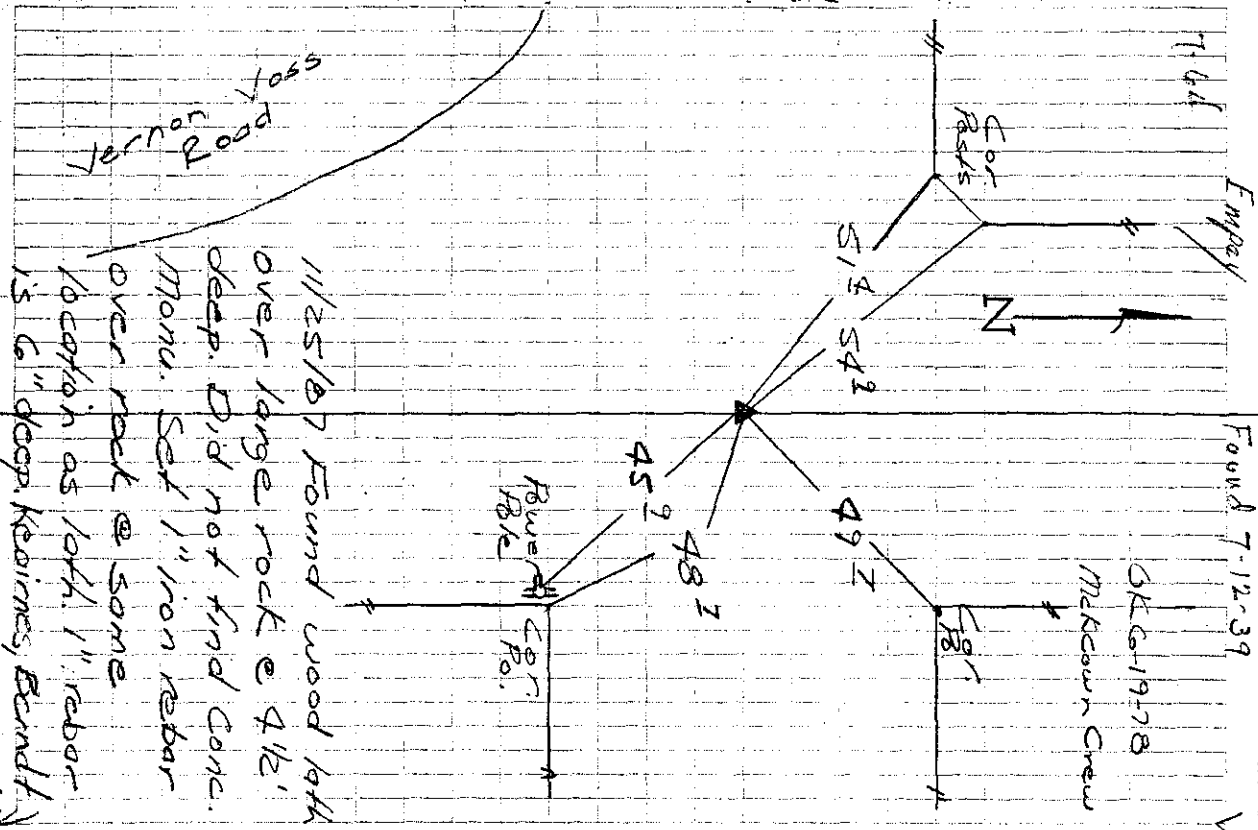

11/25/87 Found wood both  
 over large rock @ 4 1/2'  
 deep. Did not find conc.  
 Monu. Set 1" iron rebar  
 over rock @ some  
 location as both 1" rebar  
 15 6" deep. Keairnes, Berndt