


29 28

FOUND A FOOT 4x7x7"
 4x 4x5" at a depth of 16"
 1 whole brick 16" deep
 lowered to 4" set C.M.
 Ties from "X" nails
 33.41 East from Corner Post
 34.19 S.E. from Brace Post
 34.28 SW from Power Pole
 34.06 W. from Corner Post
 54.57 N.W. from Power Pole
 1.0 N. from Range of Fence W.

20
29


Found 1/2" iron rod 24" long
 1 foot 4x4x8" brick bats
 at a depth of 6' lowered
 and set C.M.
 Ties from "X" nails
 34.53 S.E. from Brace P.O.
 34.64 S.W. from Corner P.O.
 34.67 S.W. from Brace P.O.
 32.30 N. from Old Car P.O.
 1.5 W. from Range F.E. N
 1.0 S. from Q. County Road

FOUND 9-13-39 59
 9/14/91 Found Iron Pin 4"
 deep. Sandquist Crew

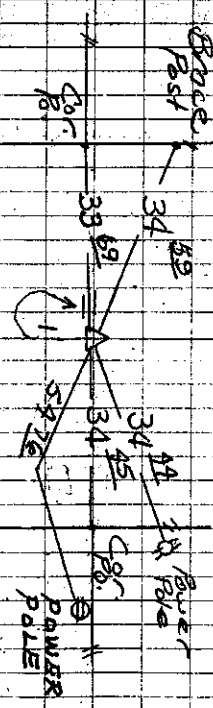

11-B-02
 FOUND 5/8" x P.O. 6" DEEP
 BERNY, QUARRY

22-53 FOUND 4-2-40

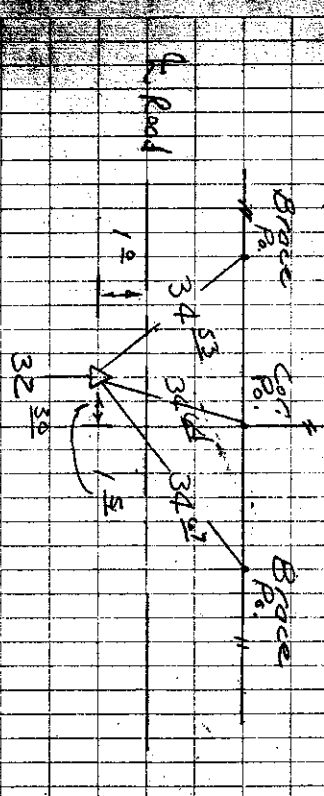

9/16/92 Found
 Iron Pin 4" deep
 Sandquist Crew Set. Sec. Con. Can. Calif.