

34 35

NE Cor 3

3 2 7-31-40 Dug - 22' x 17' x 18" hole
center of lot

Found 2 stones on side of road
that appear to be markers.
Size (6" x 4" x 8" round on
8" x 4" x 7") - 3-15-40 Champion


7/24/56

IDA COUNTY Twp 1 Range
ENGR. OFFICE Twp 1 Range
asked for plan to be
as laid would have
they this corner

11

OCT 5 1958

7275
32-475

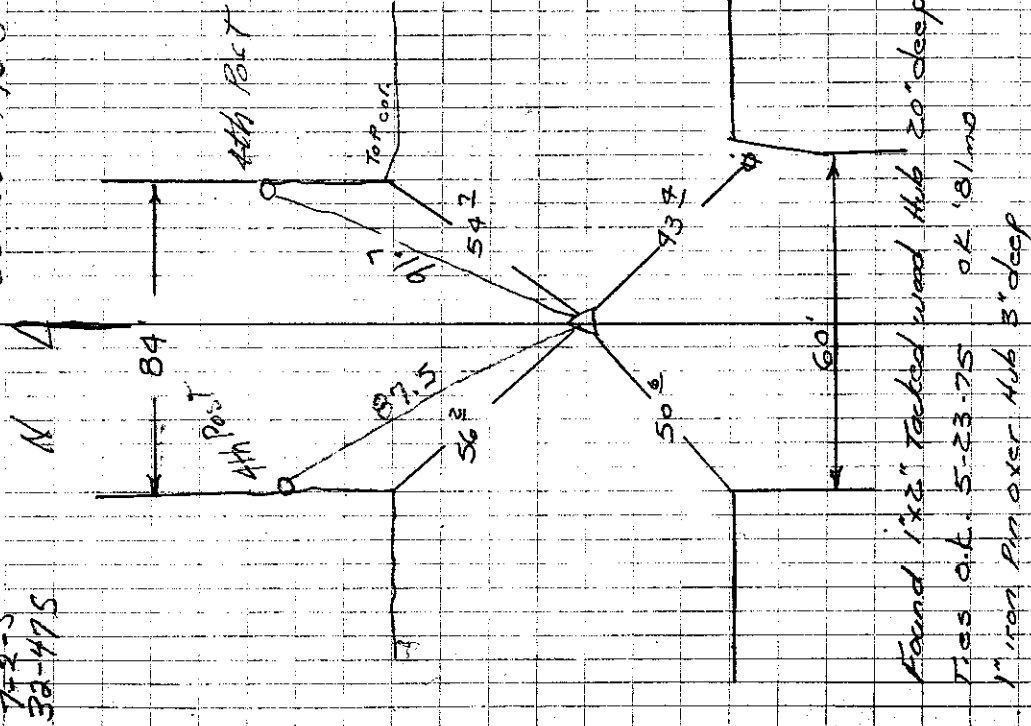

Found 1' x 3" Tacked wood Hub 20" deep
Ties O.L. 5-23-75 O.K. '81 mo
1" iron pin axsr. Hub 3" deep

13